



GROUND FLOOR PLAN

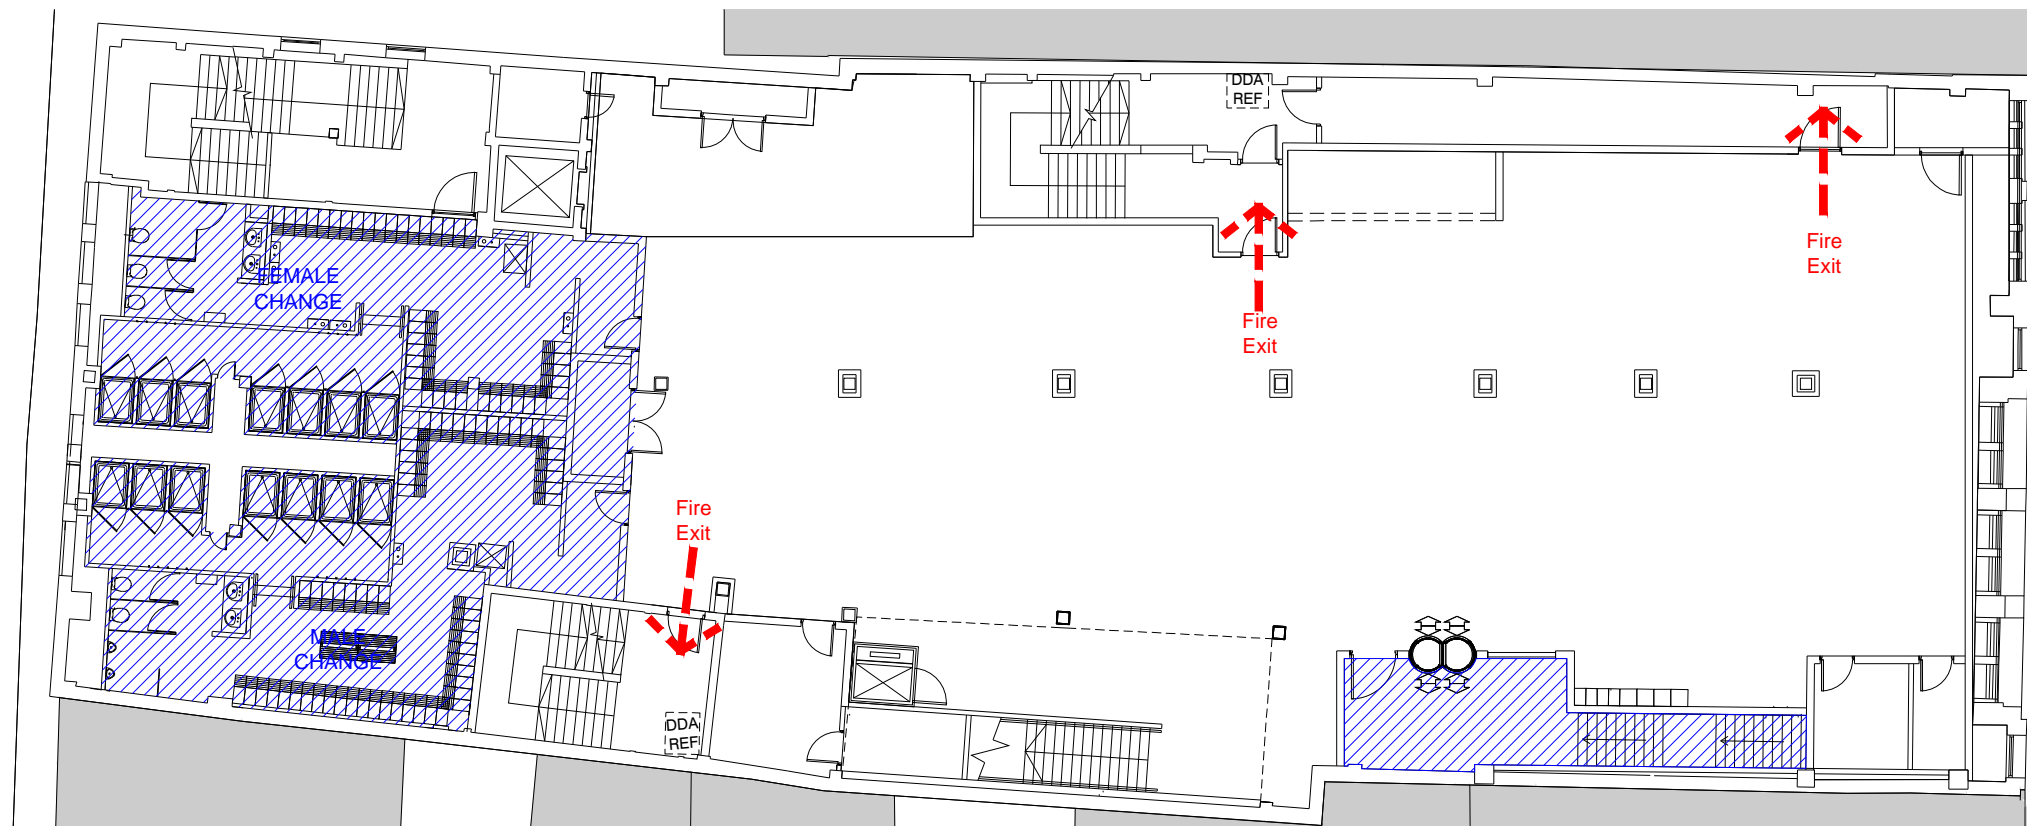


SECOND FLOOR PLAN

E	19.07.16	DRAWING AMENDED TO SHOW AS BUILT FOLLOWING SITE VISIT 18.07.16	CM	GL
D	04.07.16	COLUMN SIZES UPDATED FOLLOWING SITE MEETING; ACCESS INTO MALE SHOWERS RE-LOCATED TO ACCOMMODATE EXISTING COLUMN; DDA REF POINTS NOTED.	CM	GL
C	23.06.16	DRAWING UPDATED IN LINE WITH LATEST GA 2-201D.	CM	GL
B	31.05.16	DRAWING UPDATED IN LINE WITH LATEST GA 2-201C.	SB	GL
A	28.04.16	FIRST FLOR SPIN AREA EXTENDED TO TAKE INTO ACCOUNT VOID ABOVE. LOBBY, OFFICE AND SERVER ADJUSTED IN LINE WITH AS BUILT. BASE PLAN FIRE ESCAPE CONFIGURATIONS UPDATED IN LINE WITH EXISTING SITE. LIFT LOCATION ADJUSTED IN LINE WITH EASTWOOD'S REPORT. TITLE BLOCK UPDATED IN LINE WITH MHA RE-BRAND. JOB NUMBER UPDATED FROM 1PG01 658 TO 1PG140.	CM	GL

CLIENT <b>Pure Gym Ltd</b>			
PROJECT TITLE <b>90-100 Market Street, Manchester</b>			
DRAWING TITLE <b>Fire Evacuation Plan Ground and First Floor</b>			
DRAWING PURPOSE <b>FOR CONSTRUCTION</b>			
DRAWN / CHECKED CM/GL	DATE JAN '16	SCALE 1:200@A3	
JOB No 1PG 140	DRAWING No 2-600	STATUS --	REVISION E
51 Barton Arcade t +44 (0)161 834 1018			
Deansgate f +44 (0)161 834 4798			
Manchester e contact@mhaarchitects.com			
M3 2BJ w www.mhaarchitects.com			

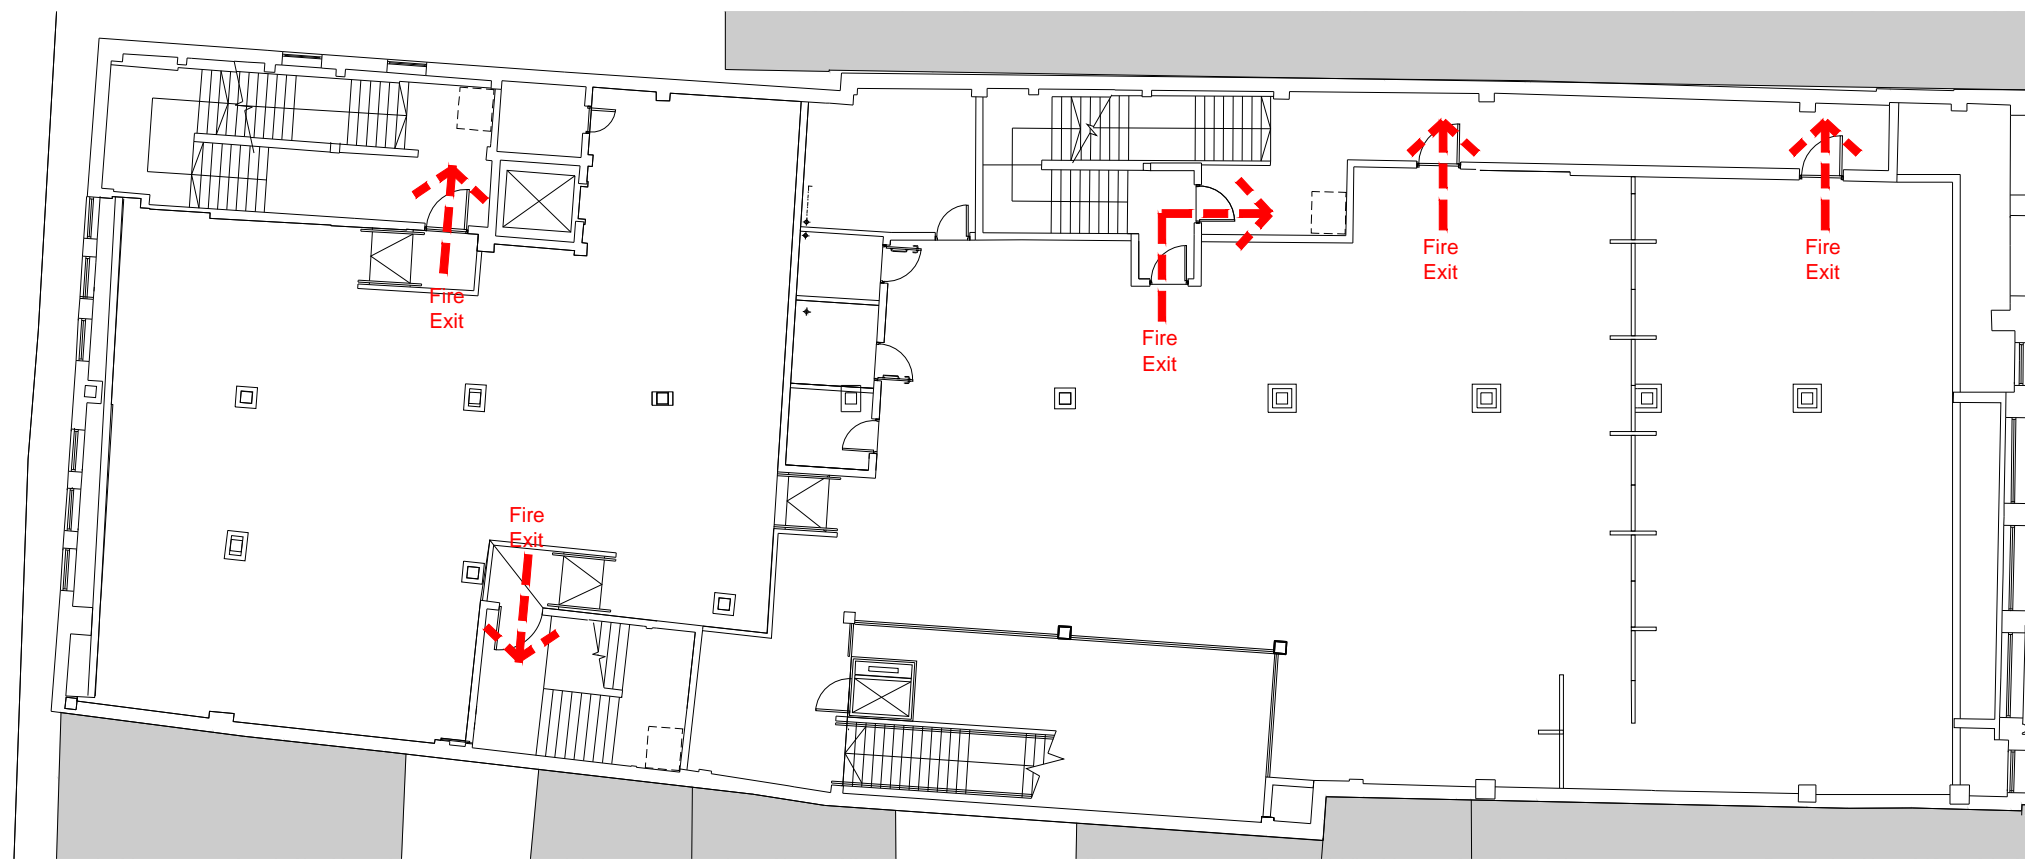

SECOND FLOOR PLAN

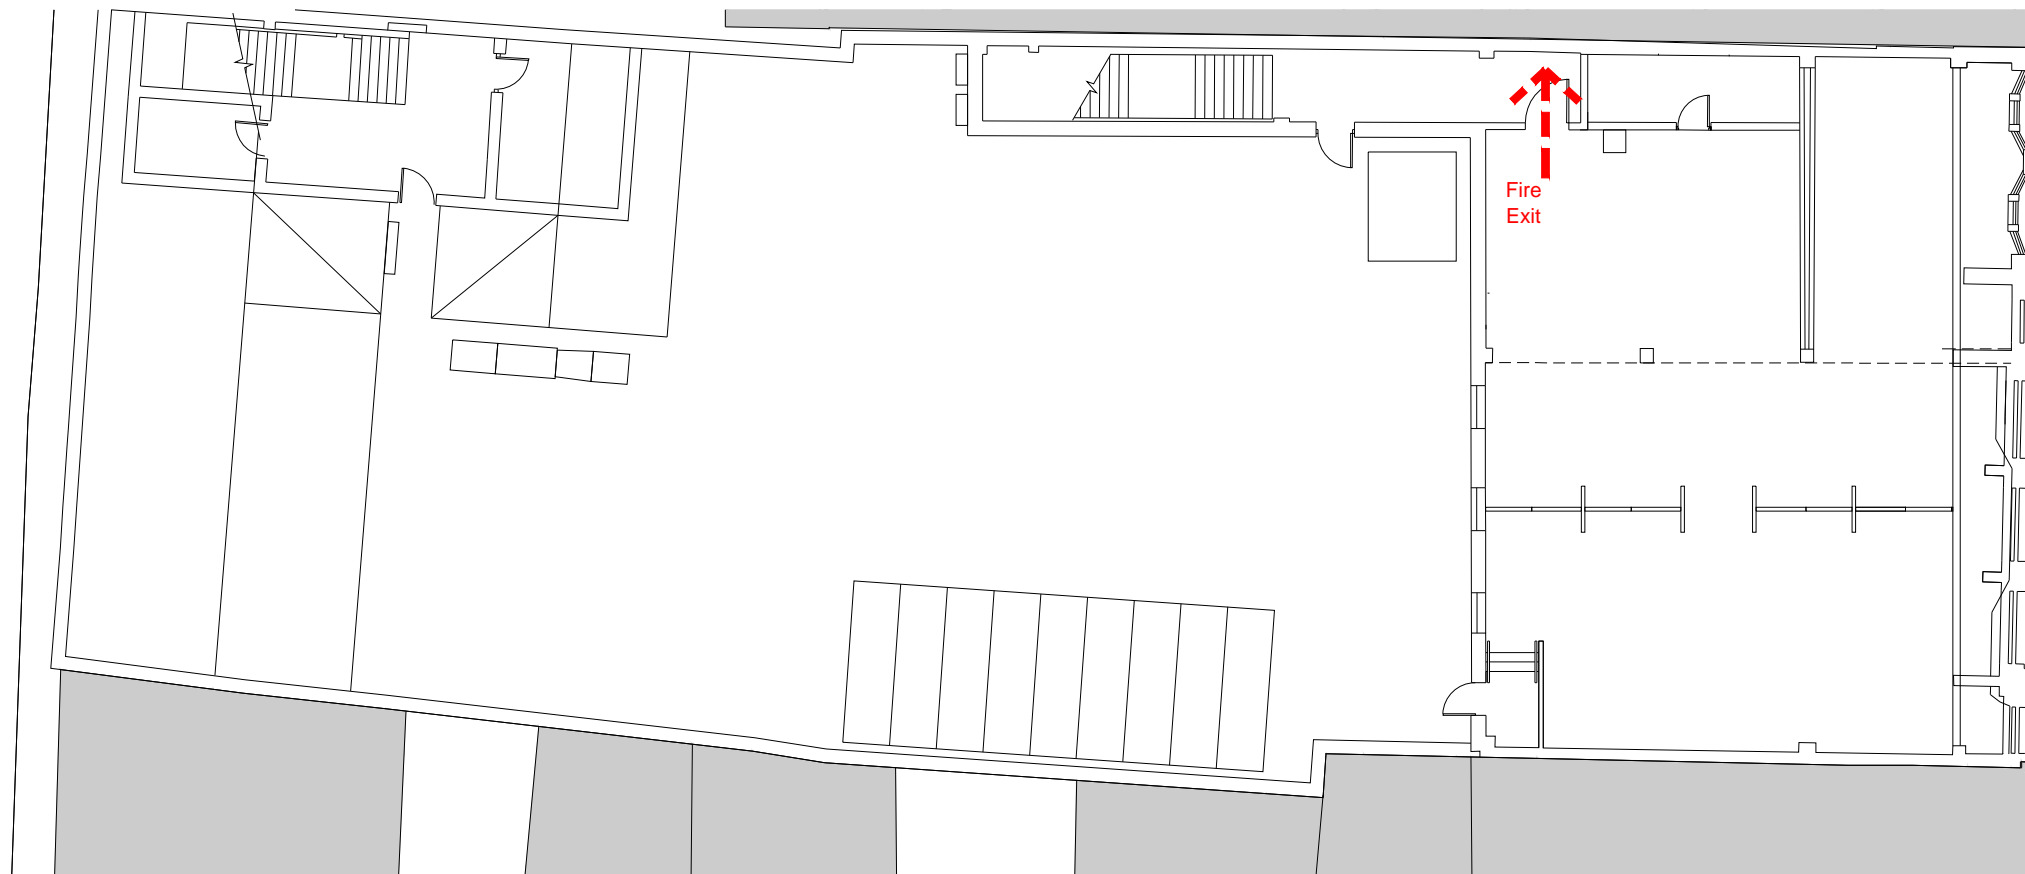

THIRD FLOOR PLAN

- F 19.07.16 COLUMN ENCASUREMENTS AND WALL TO REAR OF FREE-WEIGHTS ADDED AS BUILT. DOOR TO PLANT SHOWN AS BUILT. CM HM
- E 04.07.16 ELEC CUPBOARD ADDED CONFIGURATION OF ACC SH/ WC AND CLEANERS STORE UPDATED TO ACCOMMODATE EXISTING CLOUM WATER FONT RELOCATED TO UTILIZE EXISTING PLANT ROOM PENETRATIONS GL HM
- D 23.06.16 DRAWING UPDATED IN LINE WITH LATEST GA 2-202F / 2-203F. CM GL
- C 31.05.16 DRAWING UPDATED IN LINE WITH LATEST GA 2-202D / 2-203D. SB GL
- B 28.04.16 EXISTING CONCRETE FLOOR BEAMS REMOVED. RAMPS ADDED TO FREE WEIGHTS AREA. WATER FONT ADDED. LIFT LOCATION ADJUSTED IN LINE WITH EASTWOOD'S REPORT. TITLE BLOCK UPDATED IN LINE WITH MHA RE-BRAND. CM GL
- A 18.02.16 PRIVACY SCREEN ADDED TO STUDIO FOLLOWING NOTE FROM PG. CM GL

CLIENT			
<b>Pure Gym Ltd</b>			
PROJECT TITLE			
<b>90-100 Market Street, Manchester</b>			
DRAWING TITLE			
<b>Fire Evacuation Plan Second and Third Floor</b>			
DRAWING PURPOSE			
<b>FOR CONSTRUCTION</b>			
DRAWN / CHECKED	DATE	SCALE	
CM/GL	JAN '16	1:200@A3	
JOB No	DRAWING No	DRAWING No	STATUS
1PG 140	2-601	2-601	--
			REVISION
			F
51 Barton Arcade t +44 (0)161 834 1018 Deansgate f +44 (0)161 834 4798 Manchester e contact@mhaarchitects.com M3 2BJ w www.mhaarchitects.com			
			